
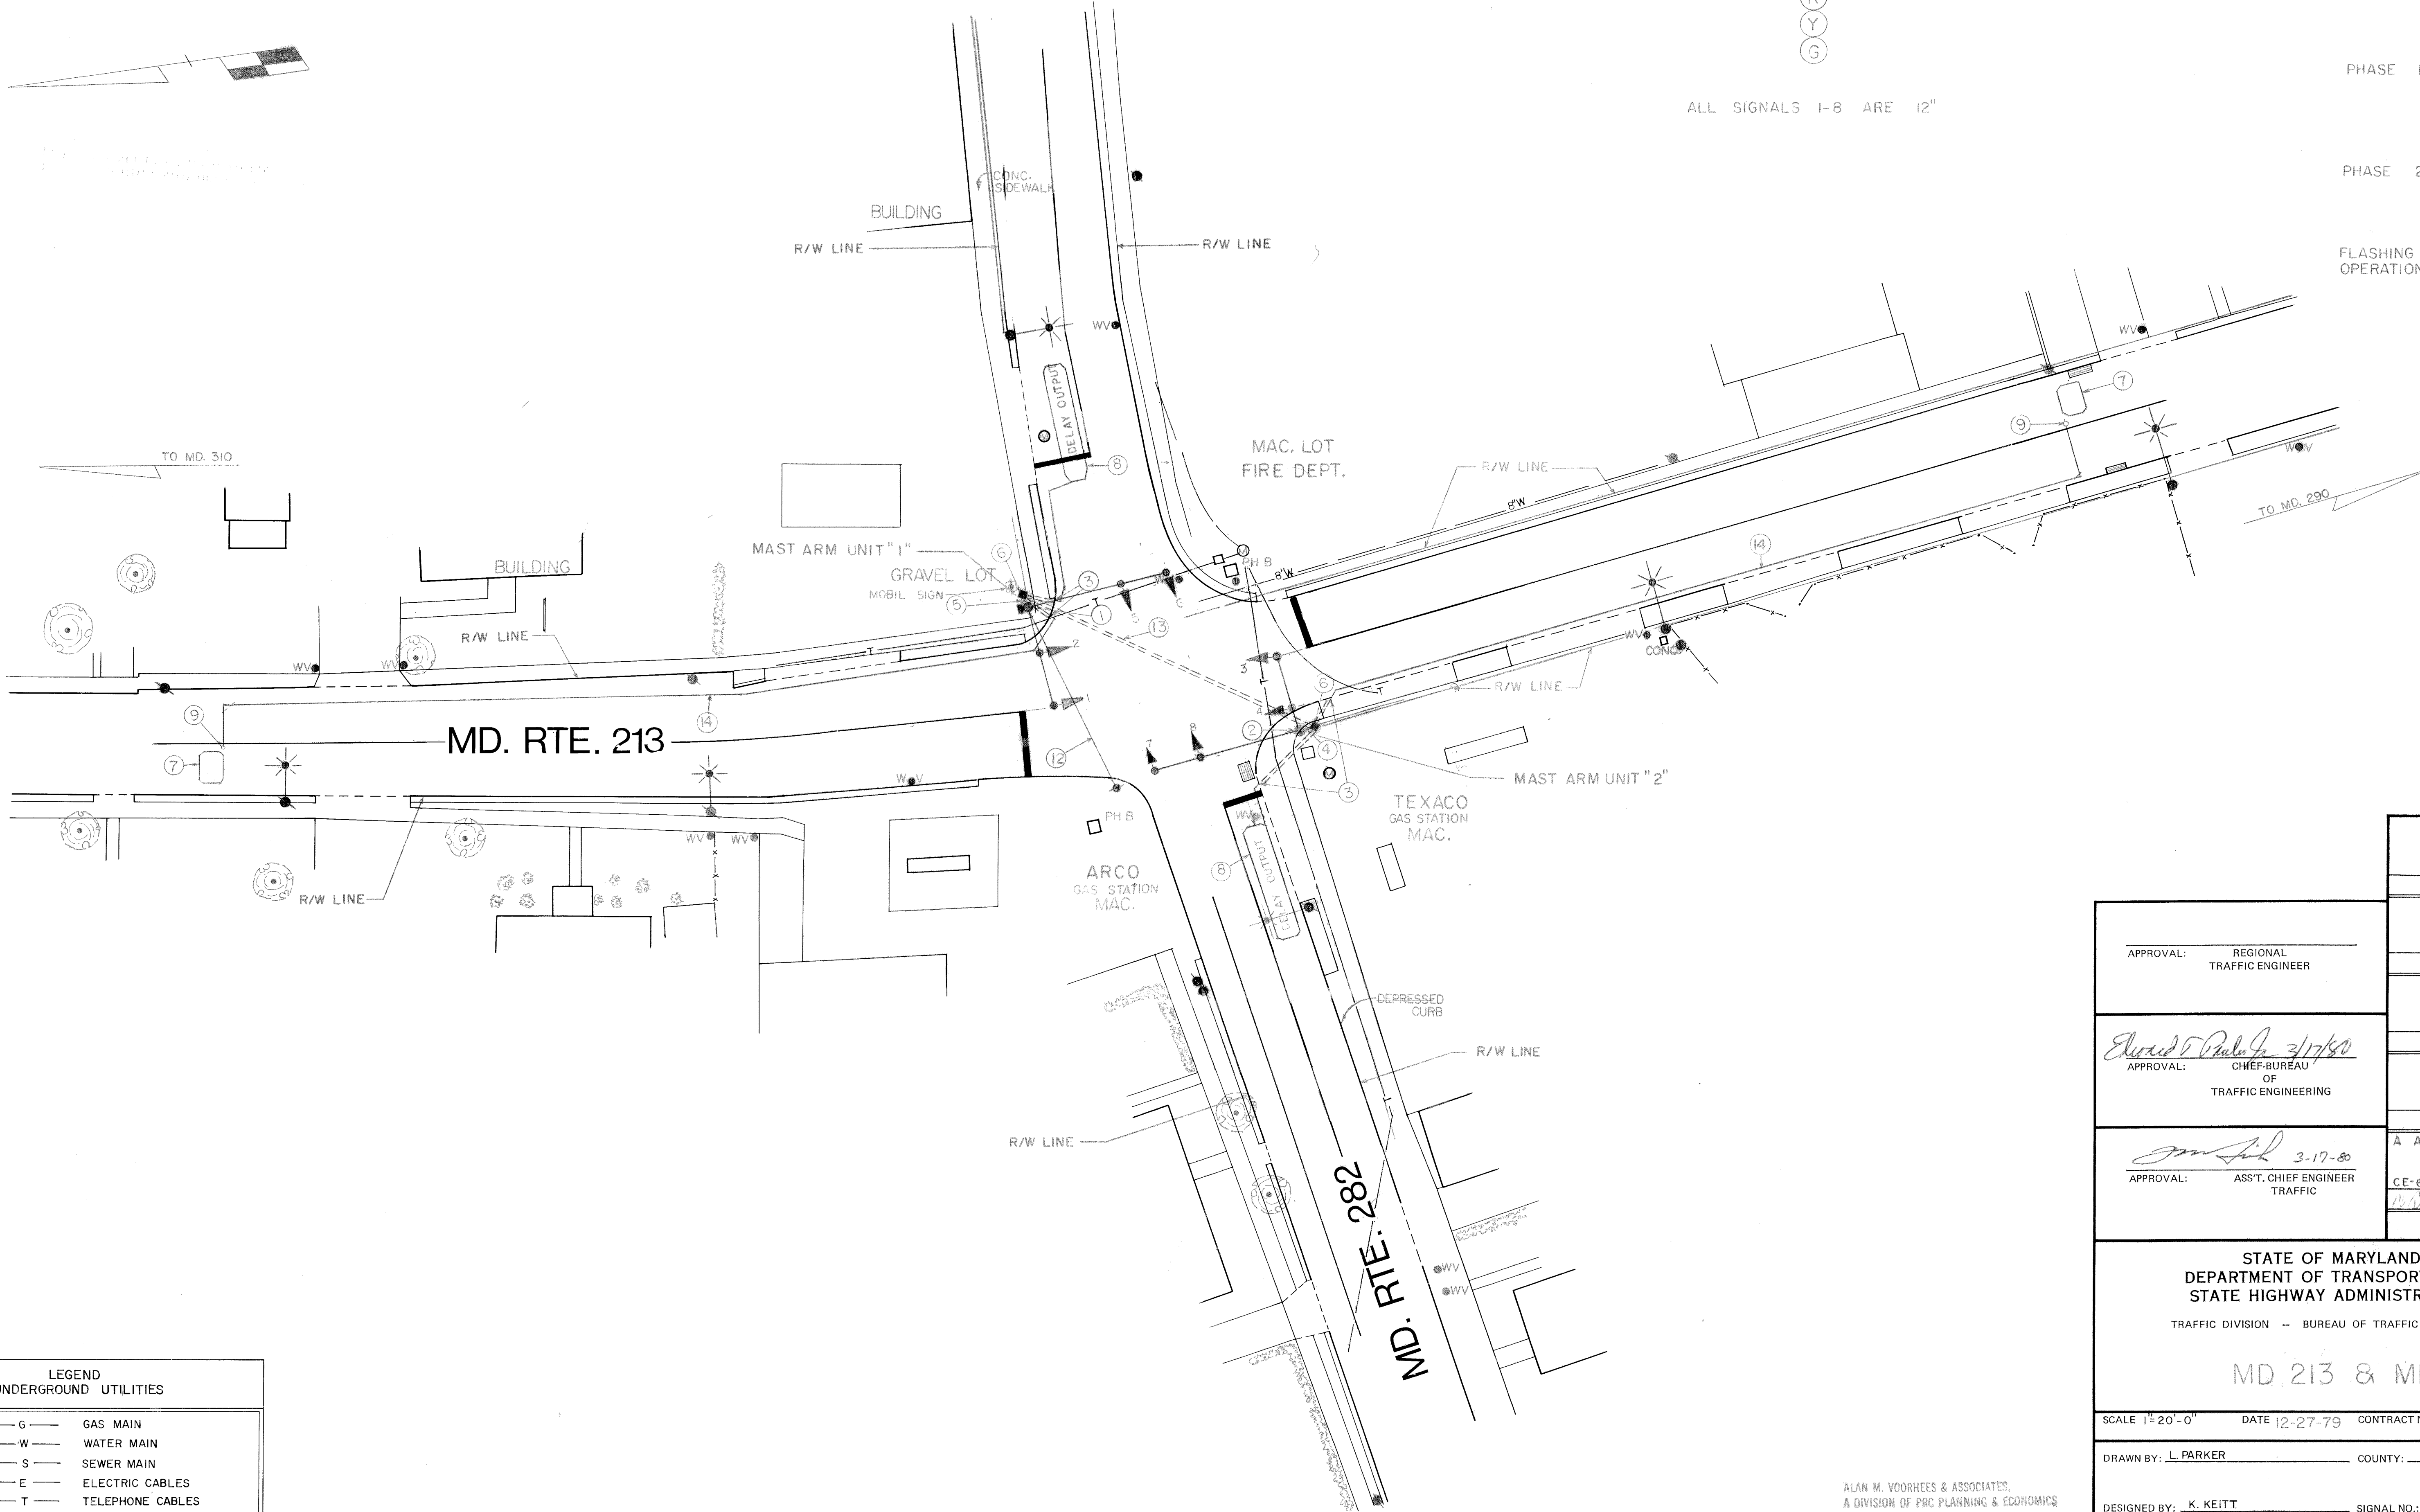


F.H.W.A. REGION NO.	STATE	FED. AID PROJ. NO.	SHEET NO.	TOTAL SHEETS
3	MD.		2	5

(R)
(Y)
(G)

ALL SIGNALS 1-8 ARE 12"

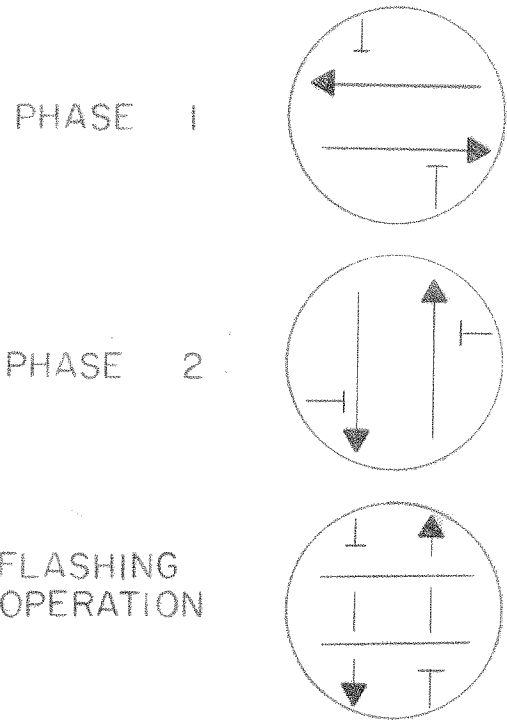

LEGEND OF UNDERGROUND UTILITIES		
— G —	G	GAS MAIN
— W —	W	WATER MAIN
— S —	S	SEWER MAIN
— E —	E	ELECTRIC CABLES
— T —	T	TELEPHONE CABLES
— A —	A	AERIAL CABLES

APPROVAL: REGIONAL
TRAFFIC ENGINEER

APPROVAL: CHIEF-BUREAU
OF
TRAFFIC ENGINEERING

APPROVAL: ASST. CHIEF ENGINEER
TRAFFIC

A ASBUILT 7-7-82

CE-612-501-285

REVISIONS

STATE OF MARYLAND
DEPARTMENT OF TRANSPORTATION
STATE HIGHWAY ADMINISTRATION

TRAFFIC DIVISION — BUREAU OF TRAFFIC ENGINEERING

MD. 213 & MD. 282

SCALE 1"=20'-0" DATE 12-27-79 CONTRACT NO.

DRAWN BY: L. PARKER COUNTY: CECIL

DESIGNED BY: K. KEITT SIGNAL NO.: 07023

CHECKED BY: [Signature] DATE 3/4/80

DRAWING NO.

TS- 306A

ALAN M. VOORHEES & ASSOCIATES,
A DIVISION OF PRC PLANNING & ECONOMICS